EXISTING AS-BUILT
FLOOR PLAN – 8 th FLOOR

SCALE 1/8" = 1'-0"

NOTE: ALL ROOM DIMENSIONS ARE APPROXIMATE

19,998 RENTABLE SQ FT

NORTH

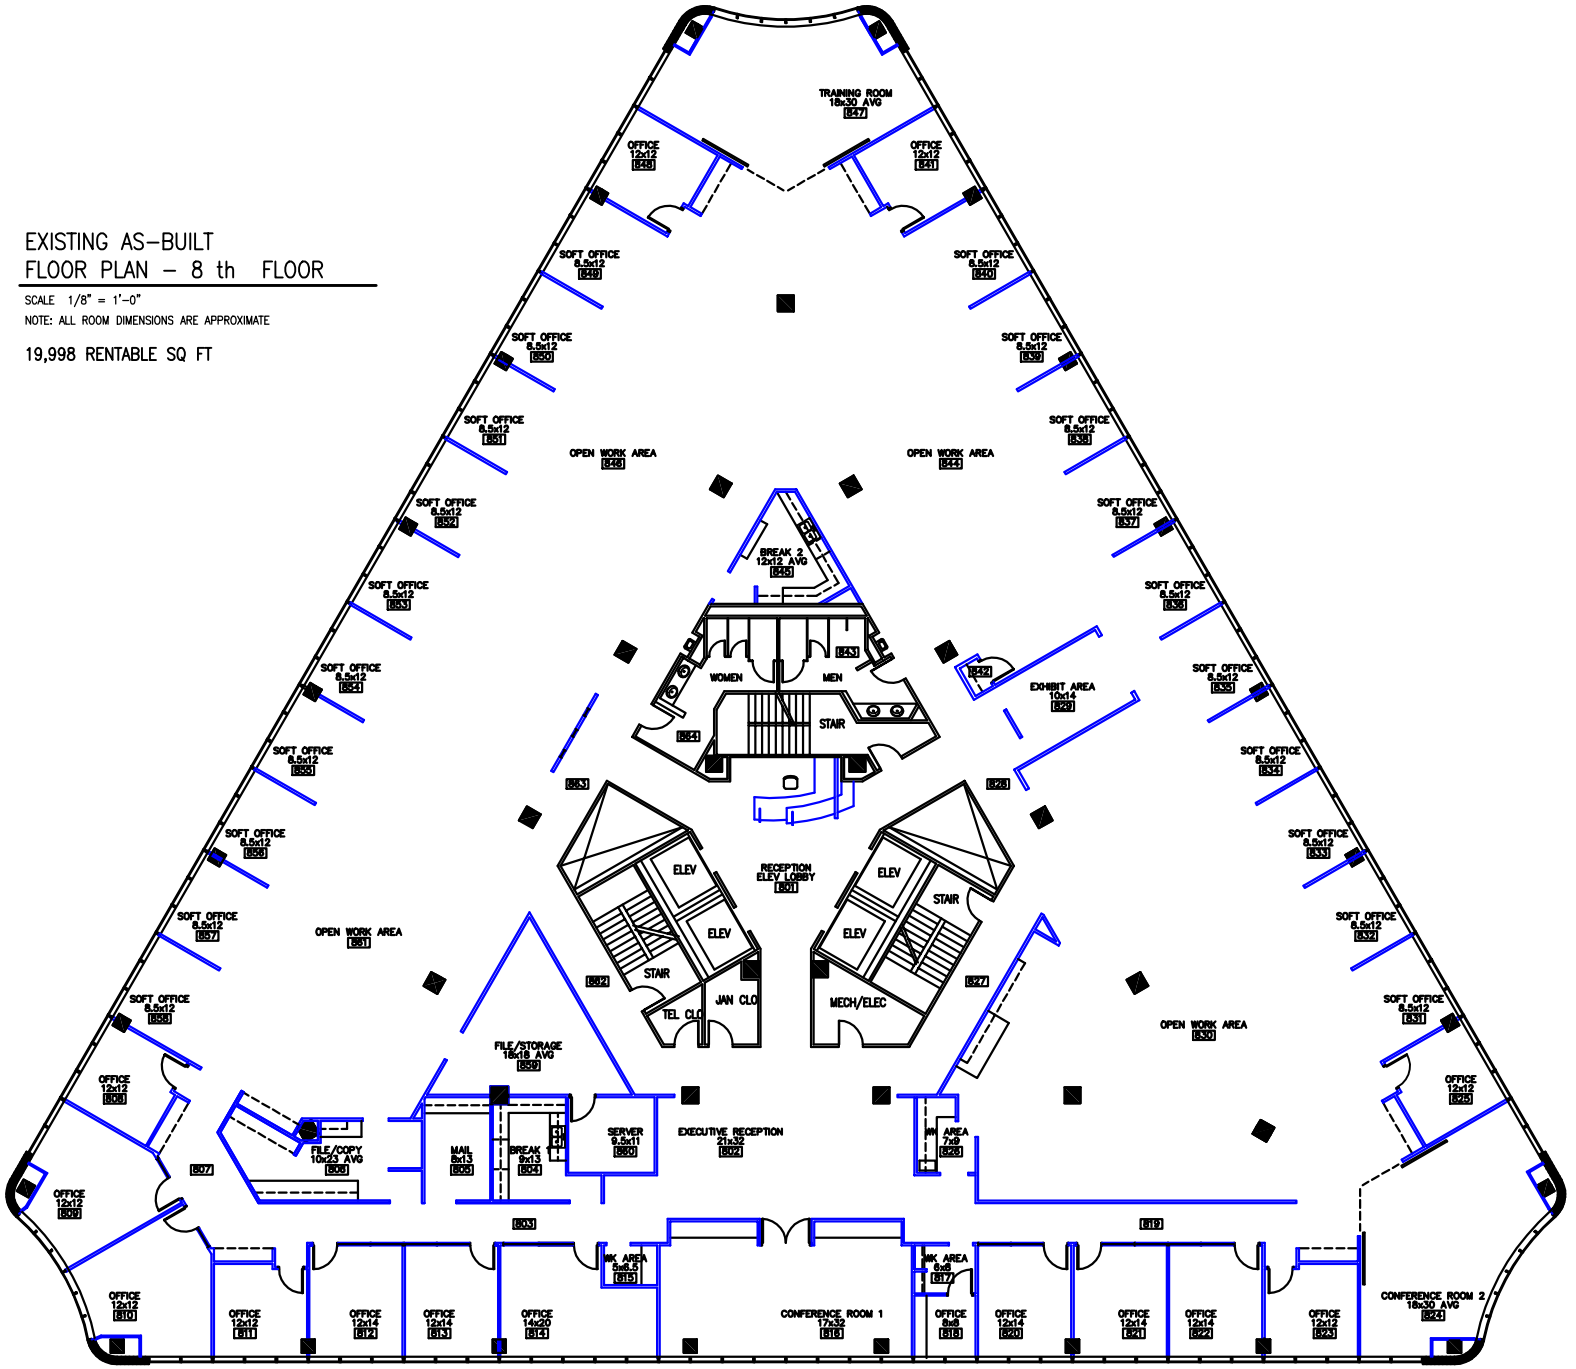

CHRISTIAN B. DILLARD
REGISTERED INTERIOR DESIGNER
4208 Clarkmore Way
Colleyville, TX. 76034
817-271-6086

SUITE 800
EXISTING

LEASE PLAN
for
BAL BAY REALTY, LTD

ONE
MOCKINGBIRD PLAZA

1420 W. MOCKINGBIRD
DALLAS, TEXAS

FLOOR PLAN
8 TH FLOOR

Date:
5-21-2013

Proposal:
EXISTING

Drawing No.:
OMP-E800-AS BUILT

Approved By:

Sheet No.:
A-1